
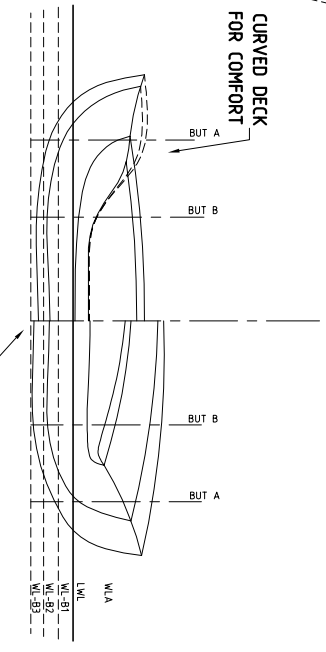
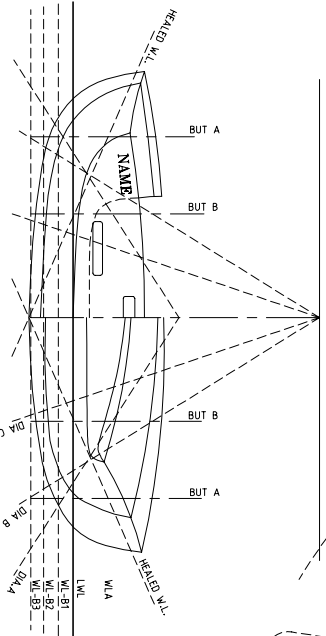


# COLE SUPER MOTH

Length O.A. 10'11 1/2"  
 Beam 4'3"  
 Draft 4 5/8"

Peter A Cole  
 25-4-1957

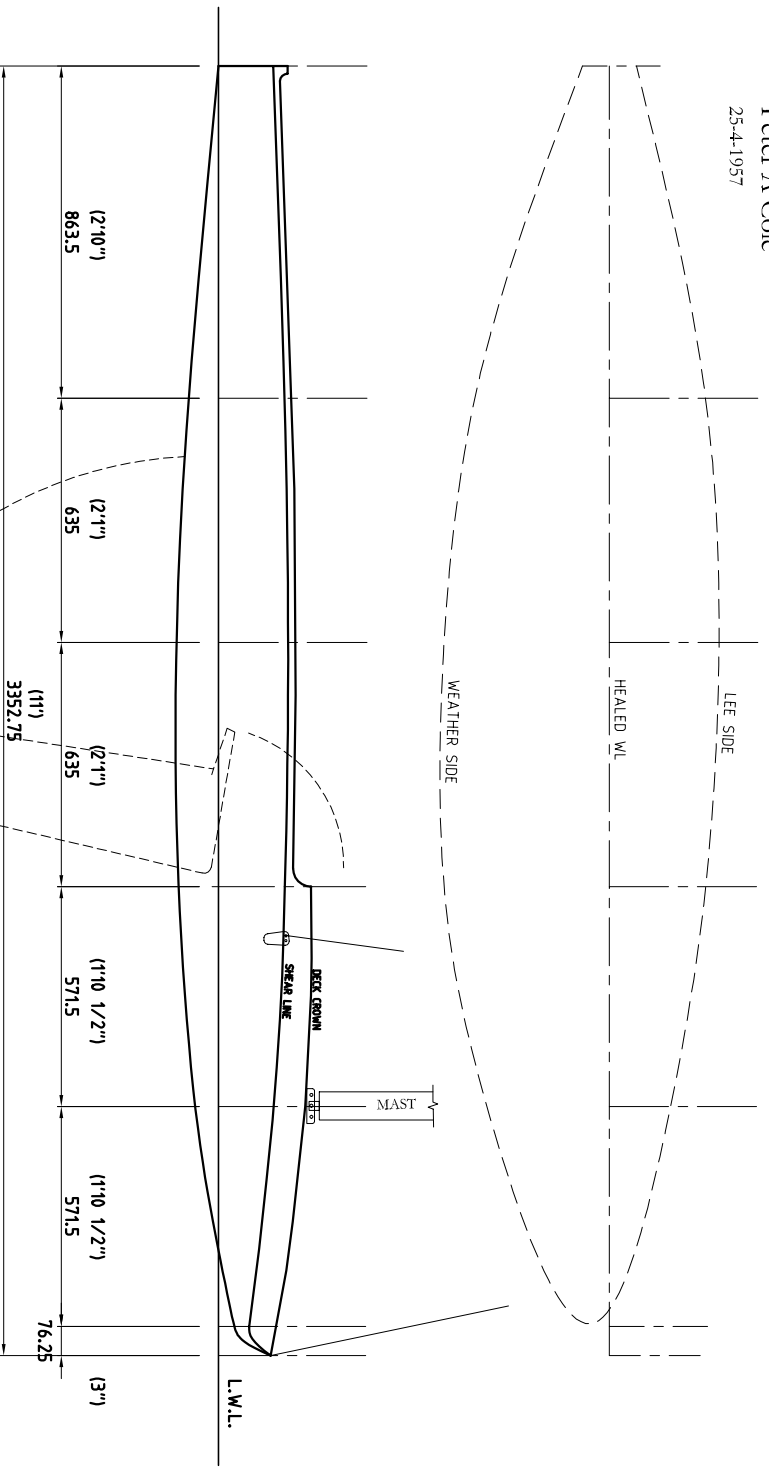

TYRO 2667  
 AS BUILT BY John Barry REYNOLDS in 1969  
 for son Douglass

